


OUTFALL	DRAINAGE AREA (Ac)	LAT/LONG (DGMS)
1	3.94	Lat: N037°31'04.69" Long: W077°34'26.48"
2	4.12	Lat: N037°30'57.23" Long: W077°34'23.64"
3	0.43	Lat: N037°30'57.44" Long: W077°34'21.93"
4	2.86	Lat: N037°30'57.39" Long: W077°34'20.51"
5	6.27	Lat: N037°30'55.28" Long: W077°34'17.70"
6	4.14	Lat: N037°30'50.78" Long: W077°34'09.24"
7	1.43	Lat: N037°30'59.20" Long: W077°34'03.37"
8	10.56	Lat: N037°31'02.69" Long: W077°34'07.56"
9	0.57	Lat: N037°31'03.45" Long: W077°34'08.28"
10	3.34	Lat: N037°31'09.85" Long: W077°34'16.60"
11	2.90	Lat: N037°31'11.19" Long: W077°34'18.48"
12	1.10	Lat: N037°31'12.66" Long: W077°34'14.25"
13	0.29	Lat: N037°31'15.32" Long: W077°34'18.12"
14	4.58	Lat: N037°31'08.87" Long: W077°34'21.34"
15	3.46	Lat: N037°30'56.68" Long: W077°34'06.71"

- RECEIVING WATER IS POWHITE CREEK (HUC 020802050607)
- RECEIVING WATER IS NOT IMPAIRED
- APPLICABLE TMDL: CHESAPEAKE BAY TMDL

**NOTES:**

- TOPOGRAPHIC, ROAD & BUILDING INFORMATION SHOWN IS FROM GIS. SELECTED AREAS HAVE BEEN UPDATED TO APPROXIMATE CURRENT CONDITIONS BY REVIEW AGAINST INTERNET BASED AERIAL PHOTOGRAPHY.
- STORM SEWER IS FROM FIELD SURVEY COMPLETED NOVEMBER 2103 SUPPLEMENTED BY RECORD DRAWINGS PROVIDED BY THE OWNER.

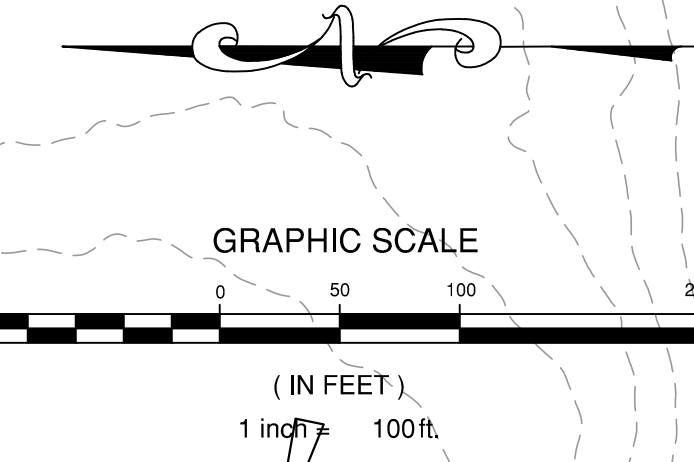

REVISIONS	
DESIGNED BY:	GHT
DRAWN BY:	SKJ
CHECKED BY:	GHC
SCALE:	1" = 100'
DATE:	JUNE 7, 2017
PROJECT NUMBER:	21162-15
	1